

Casey Jones Enterprises, Inc.

113 Jones Place
Chester, Md. 21619
410-643-4842
CaseyJonesEnt@GMail.com

To whom it may concern:

Concerning the property located at 1340 Queen Anne Drive Chester Md. 21619.
The current septic system was installed and approved by the Queen Annes County Health Department standards at the time of installation on 4/16/1971.

The distribution box was replaced in 2025 and the system was operating properly following it's installation.

QUEEN ANNE'S COUNTY HEALTH DEPARTMENT, CENTREVILLE
APPLICATION for SANITARY CONSTRUCTION PERMIT
Telephone 758-0720 — 0721

2671

1. OWNER CENTOFANTE EDWARD CENTREVILLE
last name first name address phone no.
2. BUILDER or GEN'L. CONTRACTOR (if any) E.S. ADKINS & CO. CENTREVILLE MD.
last name first name address
3. PLUMBER JAMES SEWARD CHESTER
last name first name address
4. Exact Location of Building Site LOT #20 SECTION 2 MARLING FARMS
QUEEN ANNE DRIVE
(give detailed directions so inspector can find the site)


5. Lot size: 112 feet X 135 feet
6. In Town Limits? () Yes (X) No
7. Construction and Use: (X) New? () Addition?
() Remodeling? (X) Residence? () Commercial?
() Garbage Grinder? A (X) Automatic Washer? () Fixtures
Basement
- Est. persons per 24 hr. period 3 No. bedr'ms 3

8. Water Supply: () Municipal? (X) Drilled Well?
() Dug Well? () Driven Well? () Other _____
(X) New? () Existing?
Installed by ALFRED HUDSON
Address LOVE POINT

9. Disposal System (X) Septic Tank & Tile Field?
Proposed:
() Septic Tank & Seepage Pit?
() Approved Privy?
() Other _____
Installed by JAMES SEWARD

Draw house and lot to scale (indicate scale used). Show exact location of septic tank, distribution box, irrigation trenches, pits, property lines, adjacent streets and all nearby wells. Designate direction of slope and distance to wells.

NOTE: Notify Health Dept. at least forty-eight (48) hours before you are ready to fill in trenches. Trenches must NOT be filled until the Health Dept. inspection is made and COMPLETION CERTIFICATE ISSUED.

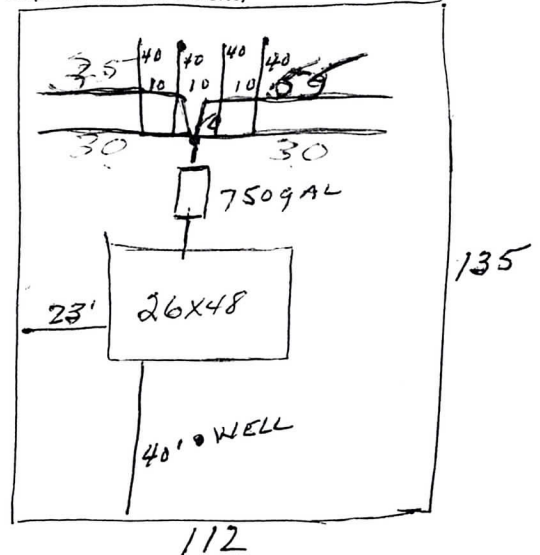

- Builder _____ Plumber _____ Owner _____
10. I, Alfred Hudson CENTREVILLE 2/17/71
signature of applicant address date of application

hereby agree to install water supply and/or sewage disposal facilities in accordance with regulations of the Maryland State Board of Health.
IMPORTANT: The applicant must arrange for necessary soil test. No construction shall be started before receiving a County Health Department Approval. Permit expires 2 yrs. after date of issue.

11. Soil Test Results: Percolation test 1 inches in 10 minutes. Depth to porous soil 6' Depth of test _____ ft.
12. Septic Tank: Liquid Capacity 750 gallons. Tank: CIV type length X width X depth Distance to any Water supply _____ ft.
13. Tile Field (if used): Total Length of tile 160 ft. Number of trenches 4 Length of each trench 40 Width of each trench 2 ft. Distance from any water supply source to nearest part of tile field 50 ft. Depth of drain tile 18"
14. Seepage Pit (if used): Total depth _____ ft. Size _____ X _____ ft. Number of pits _____ Effective depth _____ ft.
Square feet of seepage area _____ Distance from any water supply source to nearest part of seepage pit _____ ft.
15. Put drawing in area above, showing scale used - Return all copies to Health Dept. for issuance of Permit.
16. Building Permit No. 3825 Sanitary Permit No. 5192 Plumbing Permit No. 5192
17. Plans and Application approved 3-2-71 by James Morris
date Queen Anne's Health Department
18. Final Inspection 4-16-71 by ARM
date